

MARION COUNTY SURVEYOR'S OFFICE



SECTION CORNER RECORD

DEBRA S. JENKINS
MARION COUNTY SURVEYOR

SEC. 2 TWN. 14_N RNG. 2_E

BRYAN F. CATLIN, PLS
TECHNICAL SUPERVISOR

Date: 1-12-10
Party Chief: Wilcoxen
Crew: Finney
Type of Marker: RR spike
Method of Establishment: County: 4-21-1995
IN S.P.C. E Zone, NAD 83 (1986)
Name: 14020202
N: 493 417.220 0(m)
E: 47 483.832 7(m)

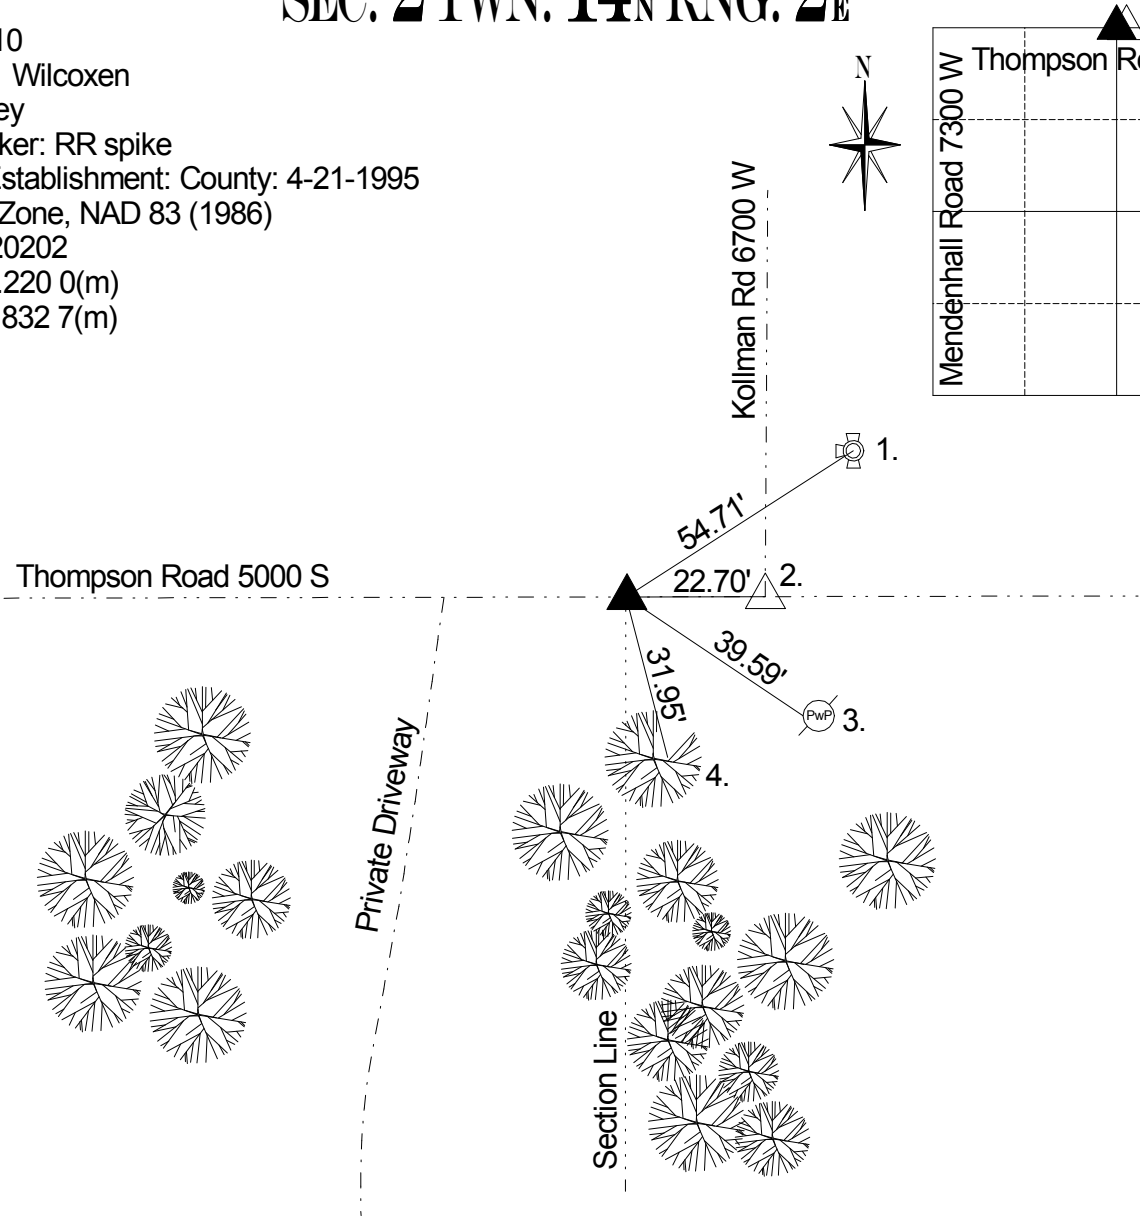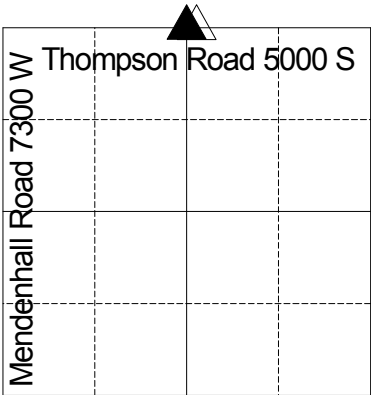

A survey by D.B. Hasbrook on March 16, 1859 indicates a stone with no witnesses (Decatur Legal Book p. 12). Wilcoxen on 3/13/1992 called an axle 6” down. Corner excavated by Wilcoxen on 4/21/1995 and a PK nail was found at surface. Dug down 24” and no stone was found. A RR spike was set at surface. Line falls on N edge of spike between South Quarter corner and Southwest corner of 35-15-2; possible North Quarter corner of 2-14-2 per Scherschel tie card. Whiteside on 2/2/2005 called a RR spike. Wilcoxen on 1/12/10 called a RR spike.

REF.	DISTANCE	DESCRIPTION
1.	54.71'	Top nut of fire hydrant
2.	22.70'	Due E to South Quarter 35-15-2 (Airport Authority monument)
3.	39.59'	Mag nail w/yellow tag W PwP #62-IPL-683-200T
4.	31.95'	PK nail w/shiner E 20" walnut 12" up